

# APPLICATION FOR PERMIT SEWER-SEWAGE DISPOSAL

1

**DIVISION OF BUILDING AND SAFETY**  
Department of County Engineer  
County of Los Angeles  
WM. J. FOX, COUNTY ENGINEER  
CASSATT D. GRIFFIN, SUP'T OF BUILDING

## FOR APPLICANT TO FILL IN

LEGAL DESCRIPTION LOT NO. 259+260  
BLOCK TRACT 7812  
SIZE OF LOT 50x90 NO. OF BLDGS. NOW ON LOT 1  
USE OF BUILDINGS Church  
CONTRACTOR L.E. Dimit  
ADDRESS 335 N. Fair Oaks  
CITY Pasadena TEL. NO. 3-1271  
REGISTRATION NO. 49685-C-36 ☐ STATE ☐ COUNTY

NO.	DESCRIPTION OF WORK	FEE
	HOUSE SEWER CONNECTING TO PUBLIC SEWER @ \$ 3.50	
	HOUSE SEWER CONNECTING TO PRIVATE DISPOSAL SYSTEM 1.00	
	CONNECT ADDITIONAL SEWER WORK TO HOUSE SEWER 1.00	<u>1.00</u>
	ALTER OR REPAIR EXISTING SEWER OR DISPOSAL SYSTEM 1.00	<u>1.00</u>
	DISCONNECT AND ABANDON SEWER AND/OR DISPOSAL SYSTEM 1.00	
	SEPTIC TANK, SEEPAGE PIT OR PITS AND/OR DRAINFIELD 2.00	
	CESSPOOL - DRYWELL SPECIAL CONDITIONS ONLY 2.00	

<b>OWNER'S AUTHORIZATION</b>	PERMIT \$	1 00
	TOTAL FEE	<u>2 00</u>

I HAVE THIS DATE CONTRACTED WITH THE HEREIN NAMED CONTRACTOR TO CONNECT THE ABOVE DESCRIBED EXISTING DWELLING TO THE PUBLIC SEWER

SIGNED THIS 7 DAY OF March 19 55

OWNER OR AGENT L.E. Dimit

ADDRESS \_\_\_\_\_

I HEREBY ACKNOWLEDGE THAT I HAVE READ THIS APPLICATION AND STATE THAT THE ABOVE IS CORRECT AND AGREE TO COMPLY WITH ALL COUNTY ORDINANCES AND STATE LAWS REGULATING PLUMBING AND SEWERS.

I HEREBY CERTIFY THAT I AM PROPERLY REGISTERED AND/OR LICENSED AS REQUIRED BY LOS ANGELES COUNTY AND STATE OF CALIFORNIA OR THAT I AM THE LEGAL OWNER OF THE ABOVE DESCRIBED RESIDENTIAL PROPERTY

SIGNATURE OF PERMITTEE RE. Dimit

BUILDING ADDRESS 4263 City Terrace  
LOCALITY City Terrace  
NEAREST CROSS ST. McKilvey  
OWNER Roman Catholic Diocese  
MAIL ADDRESS L.H.  
CITY \_\_\_\_\_ TEL. NO. \_\_\_\_\_

DISTRICT NO. 6 GROUP B 3 BK MAP PG D-21

## CONNECTION DATA

STATION \_\_\_\_\_ DEPTH \_\_\_\_\_  
MANHOLE REFERENCE UPPER \_\_\_\_\_ LOWER \_\_\_\_\_  
TYPE OF CONNECTION Y. CURB P.L. LENGTH FROM W.L. TO P.L. \_\_\_\_\_

CO. IMP. NO. 511 JOB NO. \_\_\_\_\_

TRUNK PERMIT NO. \_\_\_\_\_ ROAD PERMIT NO. \_\_\_\_\_

STATE ENCROACHMENT PERMIT NO. \_\_\_\_\_

INDUSTRIAL WASTE APPROVAL \_\_\_\_\_

## CHARGES

CONNECTION CHARGE FEE \_\_\_\_\_

REIMBURSEMENT FEE \_\_\_\_\_

APPROVALS	DATE	INSPECTOR'S SIGNATURE
NEW HOUSE SEWER		
CONNECT ADDITIONAL BUILDING OR WORK		
SEPTIC TANK, SEEP, PIT(S) AND/OR DRAINFIELD		
CESSPOOL <input type="checkbox"/> DRYWELL <input type="checkbox"/>		
ALTER, REPAIR SEWER OR SEWAGE DISPOSAL SYSTEM	<u>3-7-55</u>	<u>Leibman</u>
DISCONNECT PLUG AND ABANDON HOUSE SEWER		
BACKFILL SEPTIC TANKS <input type="checkbox"/> SEEP, PIT(S) <input type="checkbox"/> CESSPOOLS <input type="checkbox"/>		

WILLIAM J. FOX, COUNTY ENGINEER

## VALIDATION

160903R MAR 7 4

BY

DEPUTY

BY

DEPUTY

Ward

BY

DEPUTY


BY

DEPUTY

# FOR DEPARTMENT USE

## REQUIRED INFORMATION

1. INDICATE ALL BUILDINGS ON PROPERTY.
2. INDICATE AND DIMENSION SEWAGE DISPOSAL SYSTEM WITH TIE DISTANCES TO BUILDINGS AND PROPERTY LINES.
3. INDICATE SIZE OF SEPTIC TANK—DEPTH OF SEEPAGE PIT(S)—SIZE OF CESSPOOL(S)
4. INDICATE NORTH DIRECTION ON PLOT.
5. INDICATE BOTH STREETS IF CORNER.

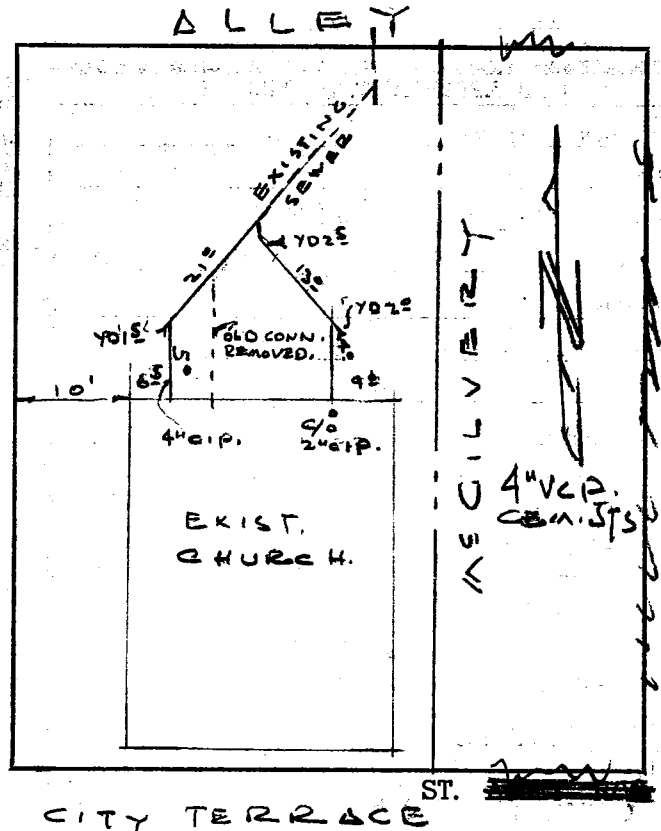

CITY TERRACE

ST. JULIA

## FIELD NOTES

TESTED & CONNECTED  
ALTERED TO LOWER HOUSE CONNECTION  
FOR TOILET RM IN BASEMENT.

005

A F M H N E O C O A